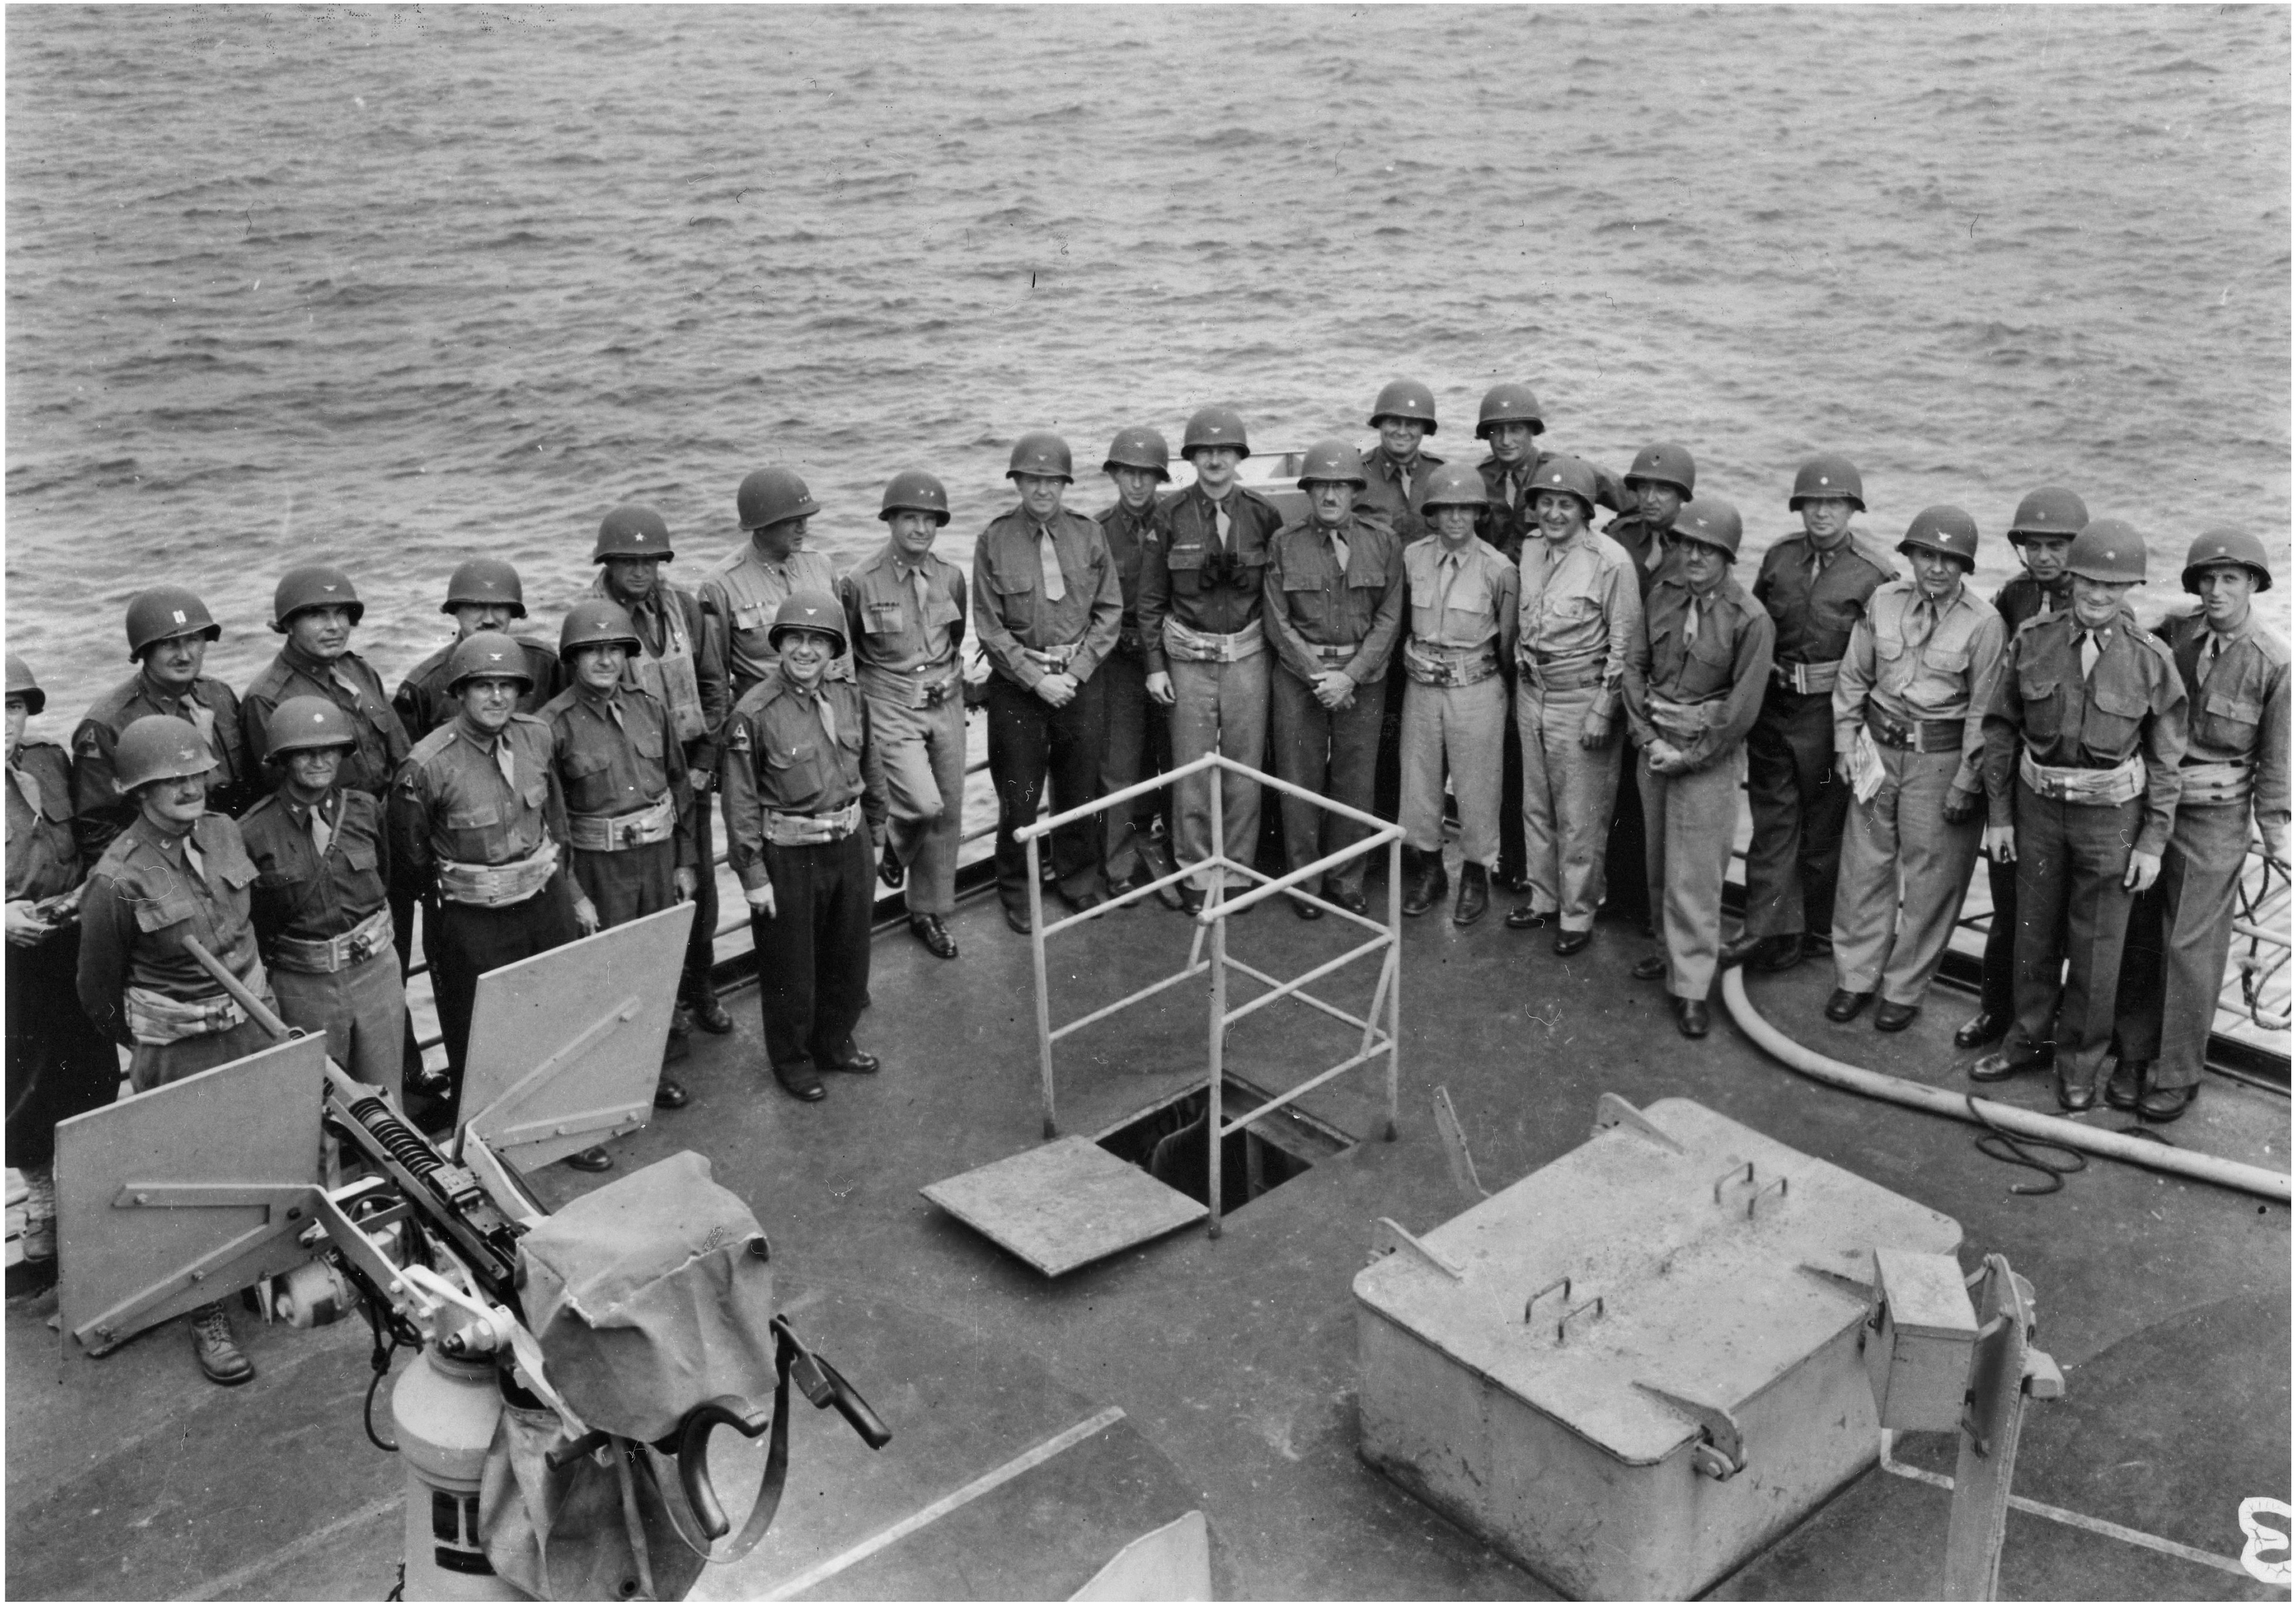

00 - cover photo

01 - cover sheet profile & deck plan

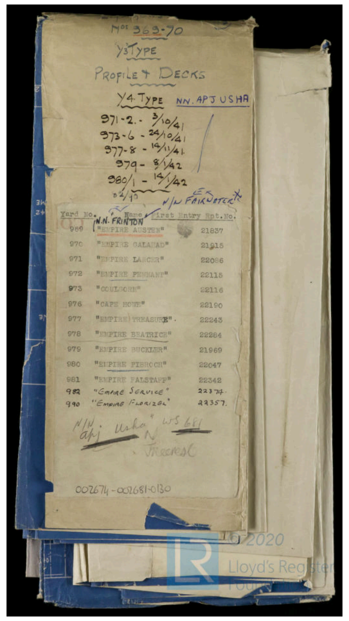

Nos 969-70

Y3 Type

Profile + Decks

Y4 Type NN. APJ USHA

971-2. - 3/10/41

973-6 - 24/10/41

977-8 - 14/11/41.

979 - 8/1/42

980/1 - 14/1/42

EX N/N FAIRWATER

N.N. FRINTON

Yard No.	Name	First Entry Rpt.No.
969	"EMPIRE AUSTEN"	21837
970	"EMPIRE GALAHAD"	21915
971	"EMPIRE LANCER"	22086
972	"EMPIRE PENNANT"	22115
973	"COULGORM"	22116
976	"CAPE HOWE"	22190
977	"EMPIRE TREASURE"	22243
978	"EMPIRE BEATRICE"	22284
979	"EMPIRE BUCKLER"	21969
980	"EMPIRE PIBROCH"	22047
981	"EMPIRE FALSTAFF"	22342
982	"Empire Service"	22374.
990	"Empire Florizel"	22357.

N/N "apj usha" WS 681

002674-002681-0130

© 2020 Lloyd's Register Foundation

02 - profile & deck plan

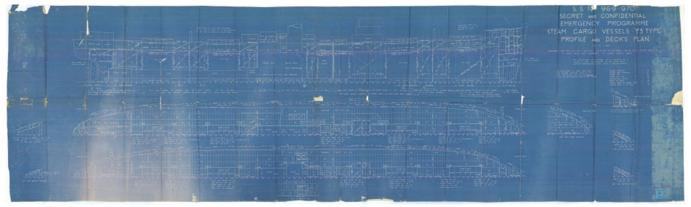

03 - cover sheet half midship section

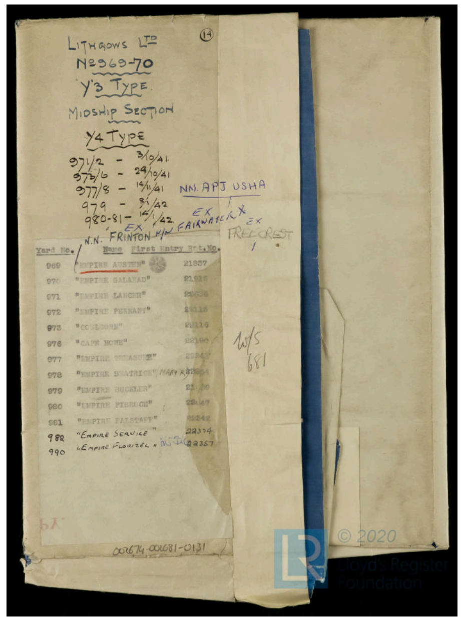

Lithgows Ltd ⑭

No 969-70

Y'3 Type.

Midship Section

Y4 Type

971/2 - 3/10/41.

973/6 - 24/10/41

977/8 - 14/11/41

979 - 8/1/42

980-81 - 14/1/42.

NN. APJ USHA

EX N/N FAIRWATER X

EX FREECREST

N.N. FRINTON

Yard No.	Name	First Entry Rpt.No.
969	"EMPIRE AUSTEN"	21837
970	"EMPIRE GALAHAD"	21915
971	"EMPIRE LANCER"	[illegible]
972	"EMPIRE PENNANT"	[illegible]
973	"COULGORM"	[illegible]
976	"CAPE HOWE"	[illegible]
977	"EMPIRE TREASURE"	[illegible]
978	"EMPIRE BEATRICE" MARY K	[illegible]
979	"EMPIRE BUCKLER"	[illegible]
980	"EMPIRE PIBROCH"	[illegible]
981	"EMPIRE FALSTAFF"	[illegible]
982	"Empire Service"	22374
990	"Empire Florizel"	22357

W/S 681

002674-002681-0131

© 2020 Lloyd's Register Foundation

04 - half midship section

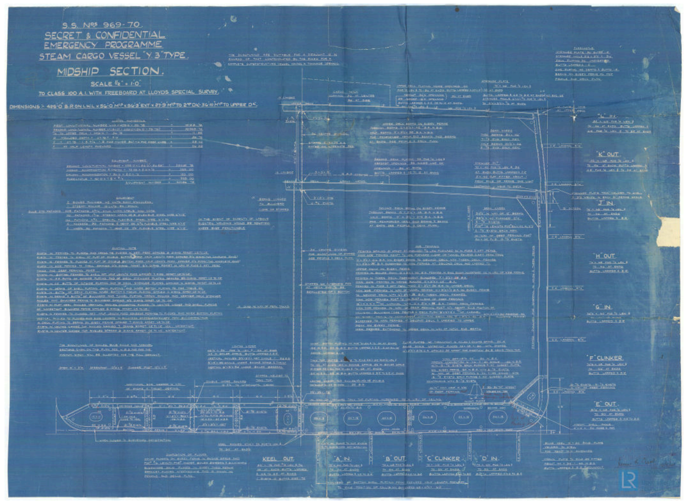

S.S. Nos 969-70.
SECRET & CONFIDENTIAL
EMERGENCY PROGRAMME
STEAM CARGO VESSEL "Y. 3" TYPE.
MIDSHIP SECTION.
SCALE 1/2" = 1'-0"
TO CLASS 100 A.1. WITH FREEBOARD AT LLOYDS SPECIAL SURVEY.
DIMENSIONS :- 425'-0" B.P. ON L.W.L. × 56'-0" MLD × 56'-3" EXT × 27'-9" MLD TO 2ND DK - 36'-10" MLD TO UPPER DK.

05 - cover sheet rudder

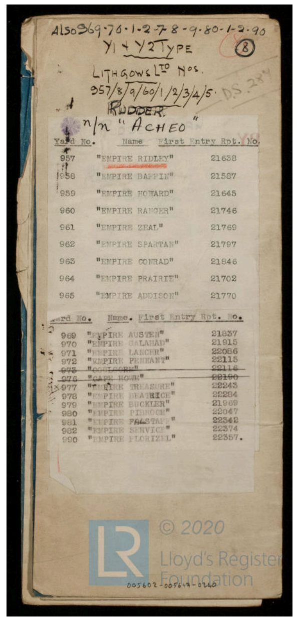

Also 969-70-1-2-7-8-9-80-1-2-90

Y1 + Y2 Type ⑧

Lithgows Ltd Nos.

957/8/9/60/1/2/3/4/5.

RUDDER.

DS 284

n/n "Acheo"

Yard No.	Name	First Entry Rpt. No.
957	"EMPIRE RIDLEY"	21638
958	"EMPIRE BAFFIN"	21587
959	"EMPIRE HOWARD"	21645
960	"EMPIRE RANGER"	21746
961	"EMPIRE ZEAL"	21769
962	"EMPIRE SPARTAN"	21797
963	"EMPIRE CONRAD"	21846
964	"EMPIRE PRAIRIE"	21702
965	"EMPIRE ADDISON"	21770

Yard No.	Name.	First Entry Rpt. No.
969	"EMPIRE AUSTEN"	21837
970	"EMPIRE GALAHAD"	21915
971	"EMPIRE LANCER"	22086
972	"EMPIRE PENNANT"	22115
~~973~~	~~"COULGORM"~~	~~22116~~
~~976~~	~~"CAPE HOWE"~~	~~22190~~
977	"EMPIRE TREASURE"	22243
978	"EMPIRE BEATRICE"	22284
979	"EMPIRE BUCKLER"	21969
980	"EMPIRE PIBROCH"	22047
981	"EMPIRE FALSTAFF"	22342
982	"EMPIRE SERVICE"	22374
990	"EMPIRE FLORIZEL"	22357.

005602-005617-0240

© 2020 Lloyd's Register Foundation

06 - rudder

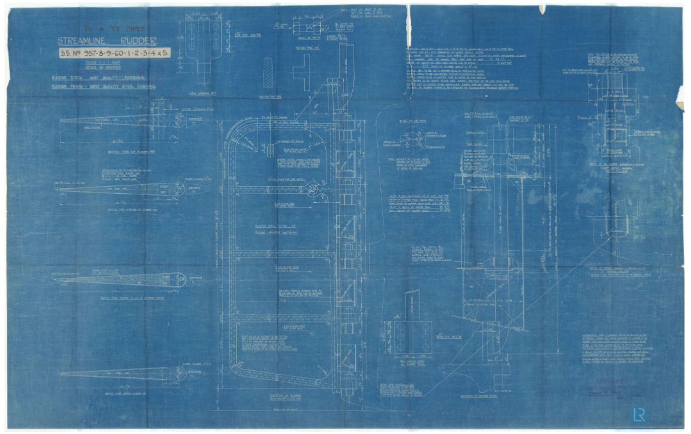
Y1 & Y2 TYPES
STREAMLINE RUDDER
S.S. Nº 957-8-9-60-1-2-3-4 & 5.
SCALE 1" = 1 FOOT
DETAILS AS INDICATED
RUDDER STOCK - BEST QUALITY FORGING.
RUDDER FRAME - BEST QUALITY STEEL CASTING.
VIEW LOOKING AFT